


E-410 A/B/C
AIR X-CHANGER
 MODEL 144EH-108-22
 A: 4378 kPa @ -29°C/149°C
 B: 9067 kPa @ -29°C/149°C
 C: 10238 kPa @ -29°C/149°C

V-150
2nd STAGE SUCTION SCRUBBER
 SIZE: 610 O.D. x 1876 S/S
 MAWP: 4516 kPa @ -29°C/149°C
 S/N: WF97801
 CRN: K8068.2
 CA: 3.2mm

V-160
3rd STAGE SUCTION SCRUBBER
 SIZE: 610 O.D. x 1826 S/S
 MAWP: 9067 kPa @ -29°C/149°C
 S/N: WF97802
 CRN: A3215.32
 CA: 3.2mm

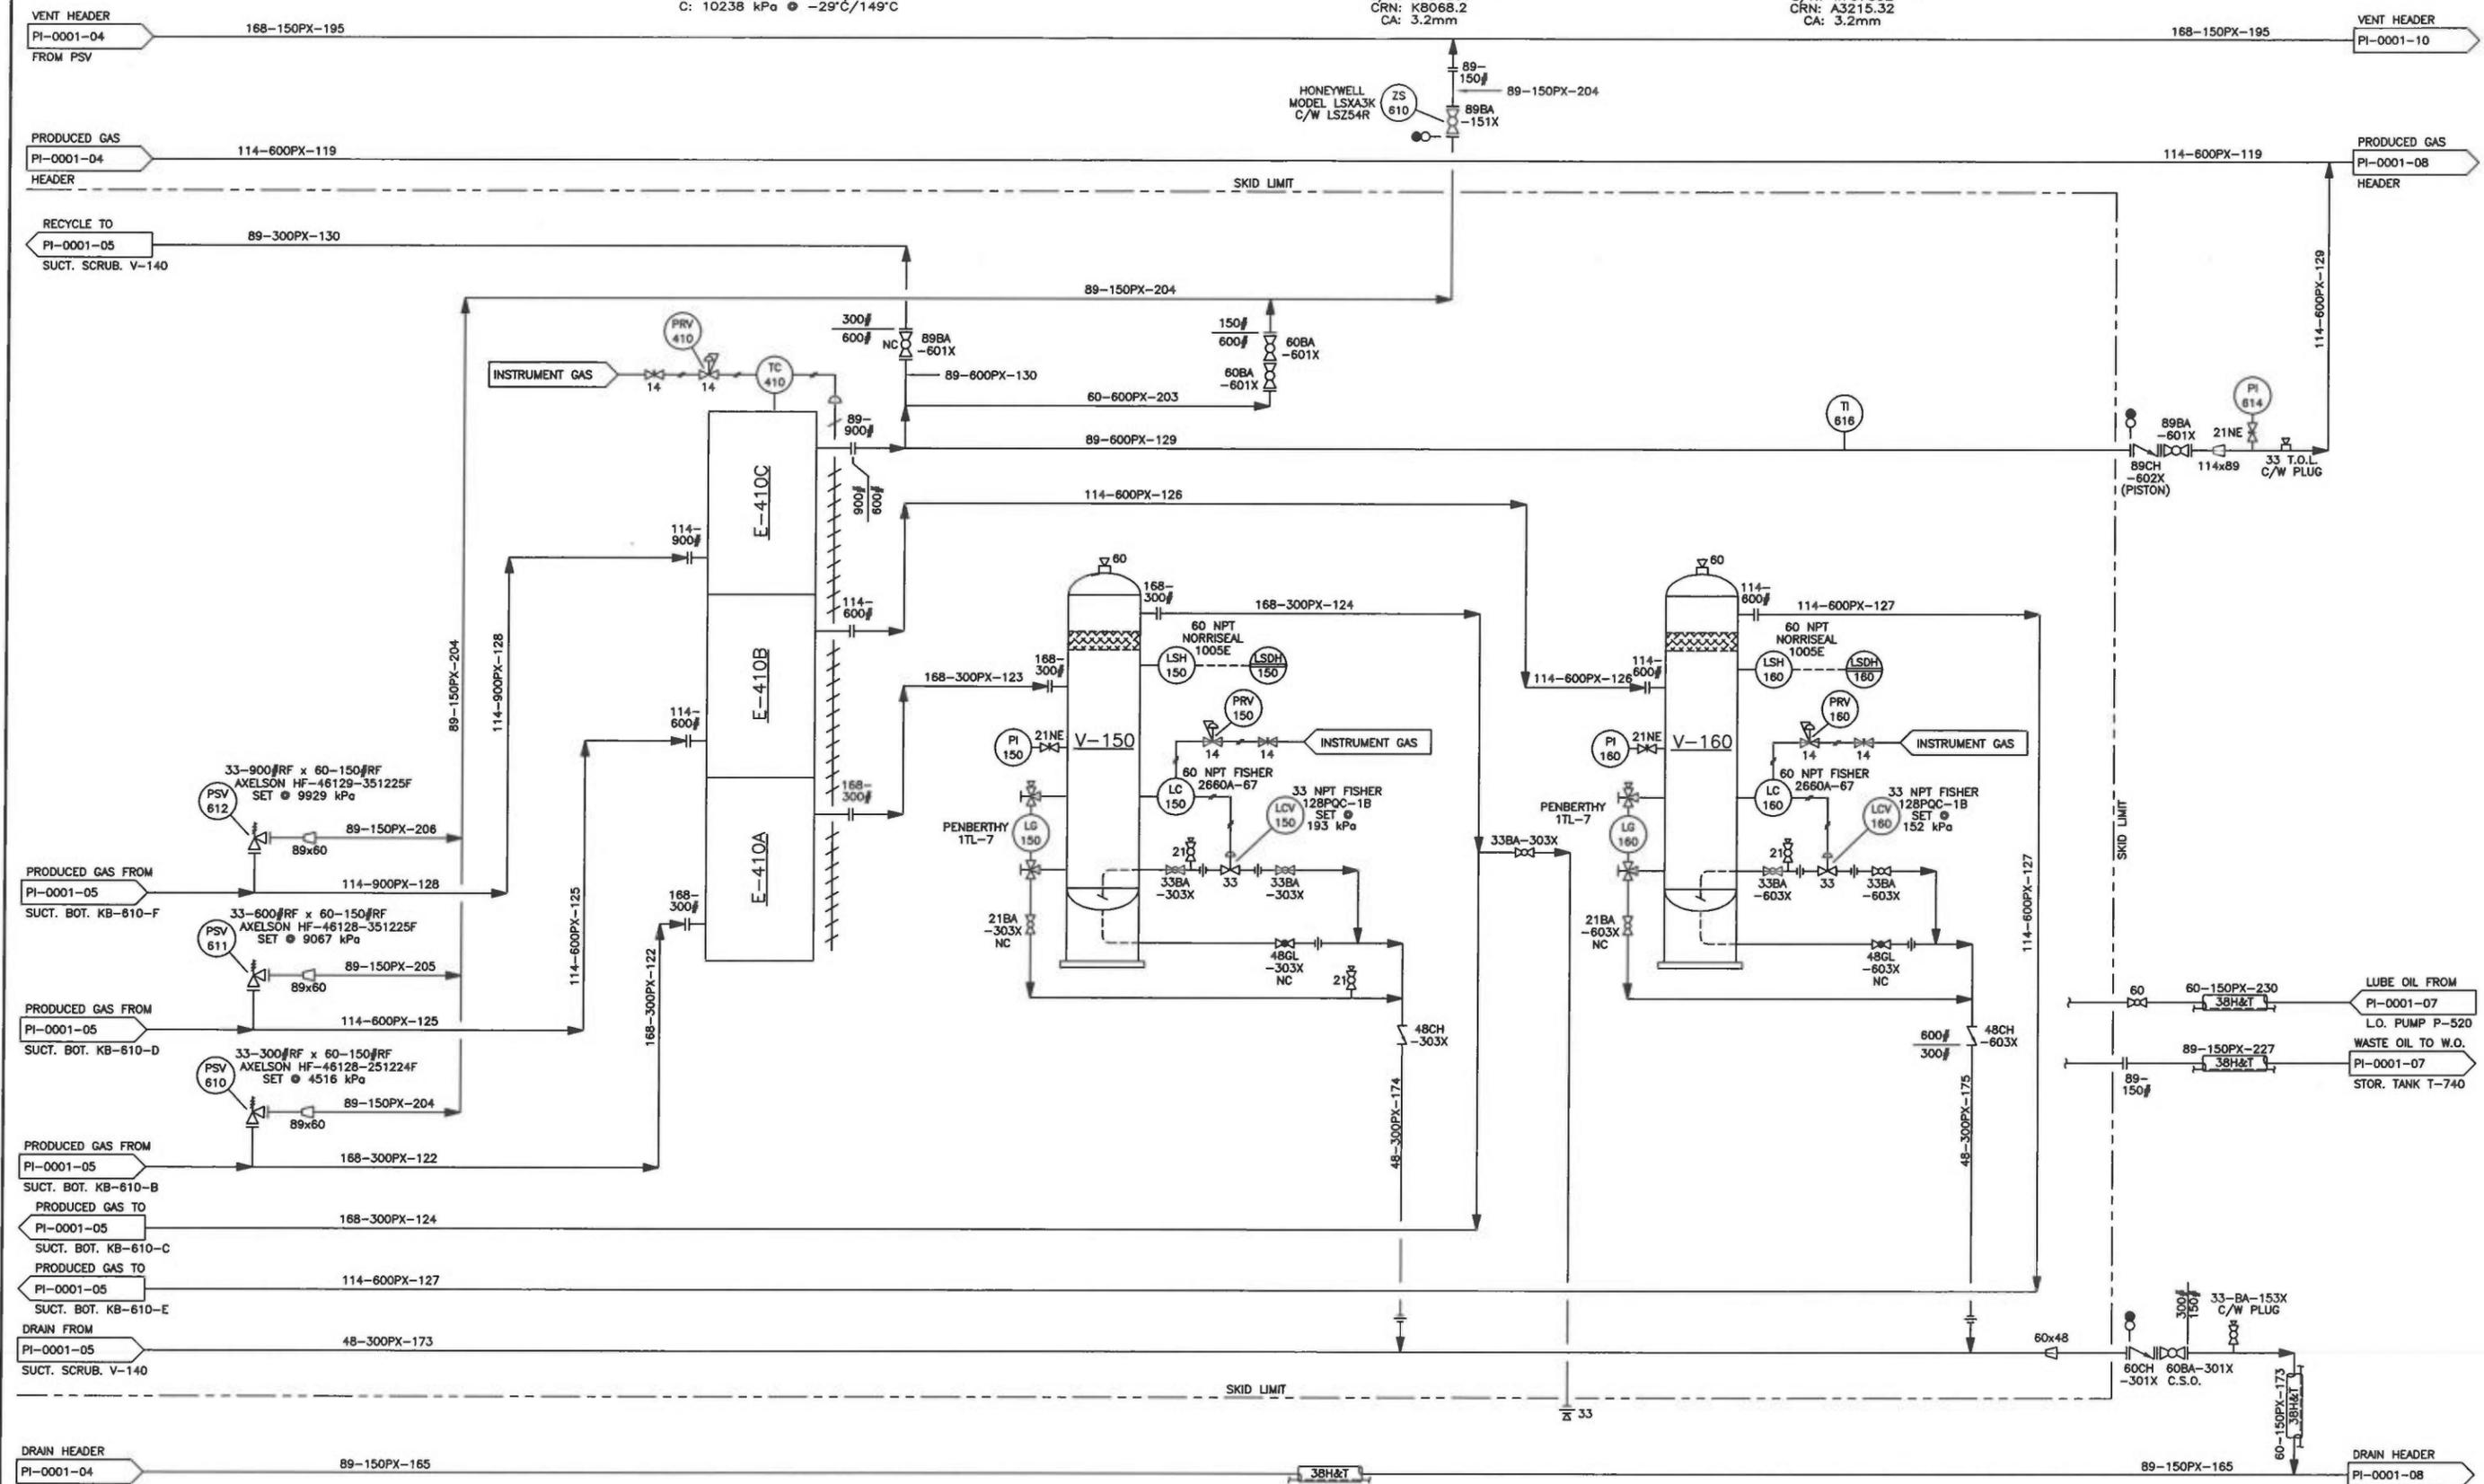


REF DWG NO	REFERENCE DRAWING DESCRIPTION	NO	REVISION HISTORY	REV AUTHOR	REV DATE	ISSUED FOR	NO	CURRENT REVISION	ISSUED FOR	AS-BUILT
		8	F-02389-F-00-01 REV.6 CONVERTED TO DWGS. PI-0001-01 TO 15	JM	05.02.21	REVISION	9	AS-BUILT (JOB #2374.00)	DOC DATE	01.07.19
		9	AS-BUILT (JOB #2374.00)	JM	05.02.21	AS-BUILT			DOC AUTHOR	CR
		10							SCALE	NTS
		11							ALTERNATE IDENTIFIER	
		12							SURFACE	LSD
		13							09-13-106-01W6	
		14							DOCUMENT IDENTIFIER	PI-0001-06



STEEN RIVER
 LSD 09-13-106-01 W6M
 COMPRESSOR STATION
 PIPING & INSTRUMENTATION DIAGRAM

FILE NAME: G:\2374.00\MECH\PI-0001-06.DWG --- MENU: C:\PROGRAM FILES\AUTOCAD 2002\SUPPORT\ACAD --- PLOTTED: 2005.05.04 7:05am --- rden
 CAD DRAWING: DO NOT CHANGE MANUALLY

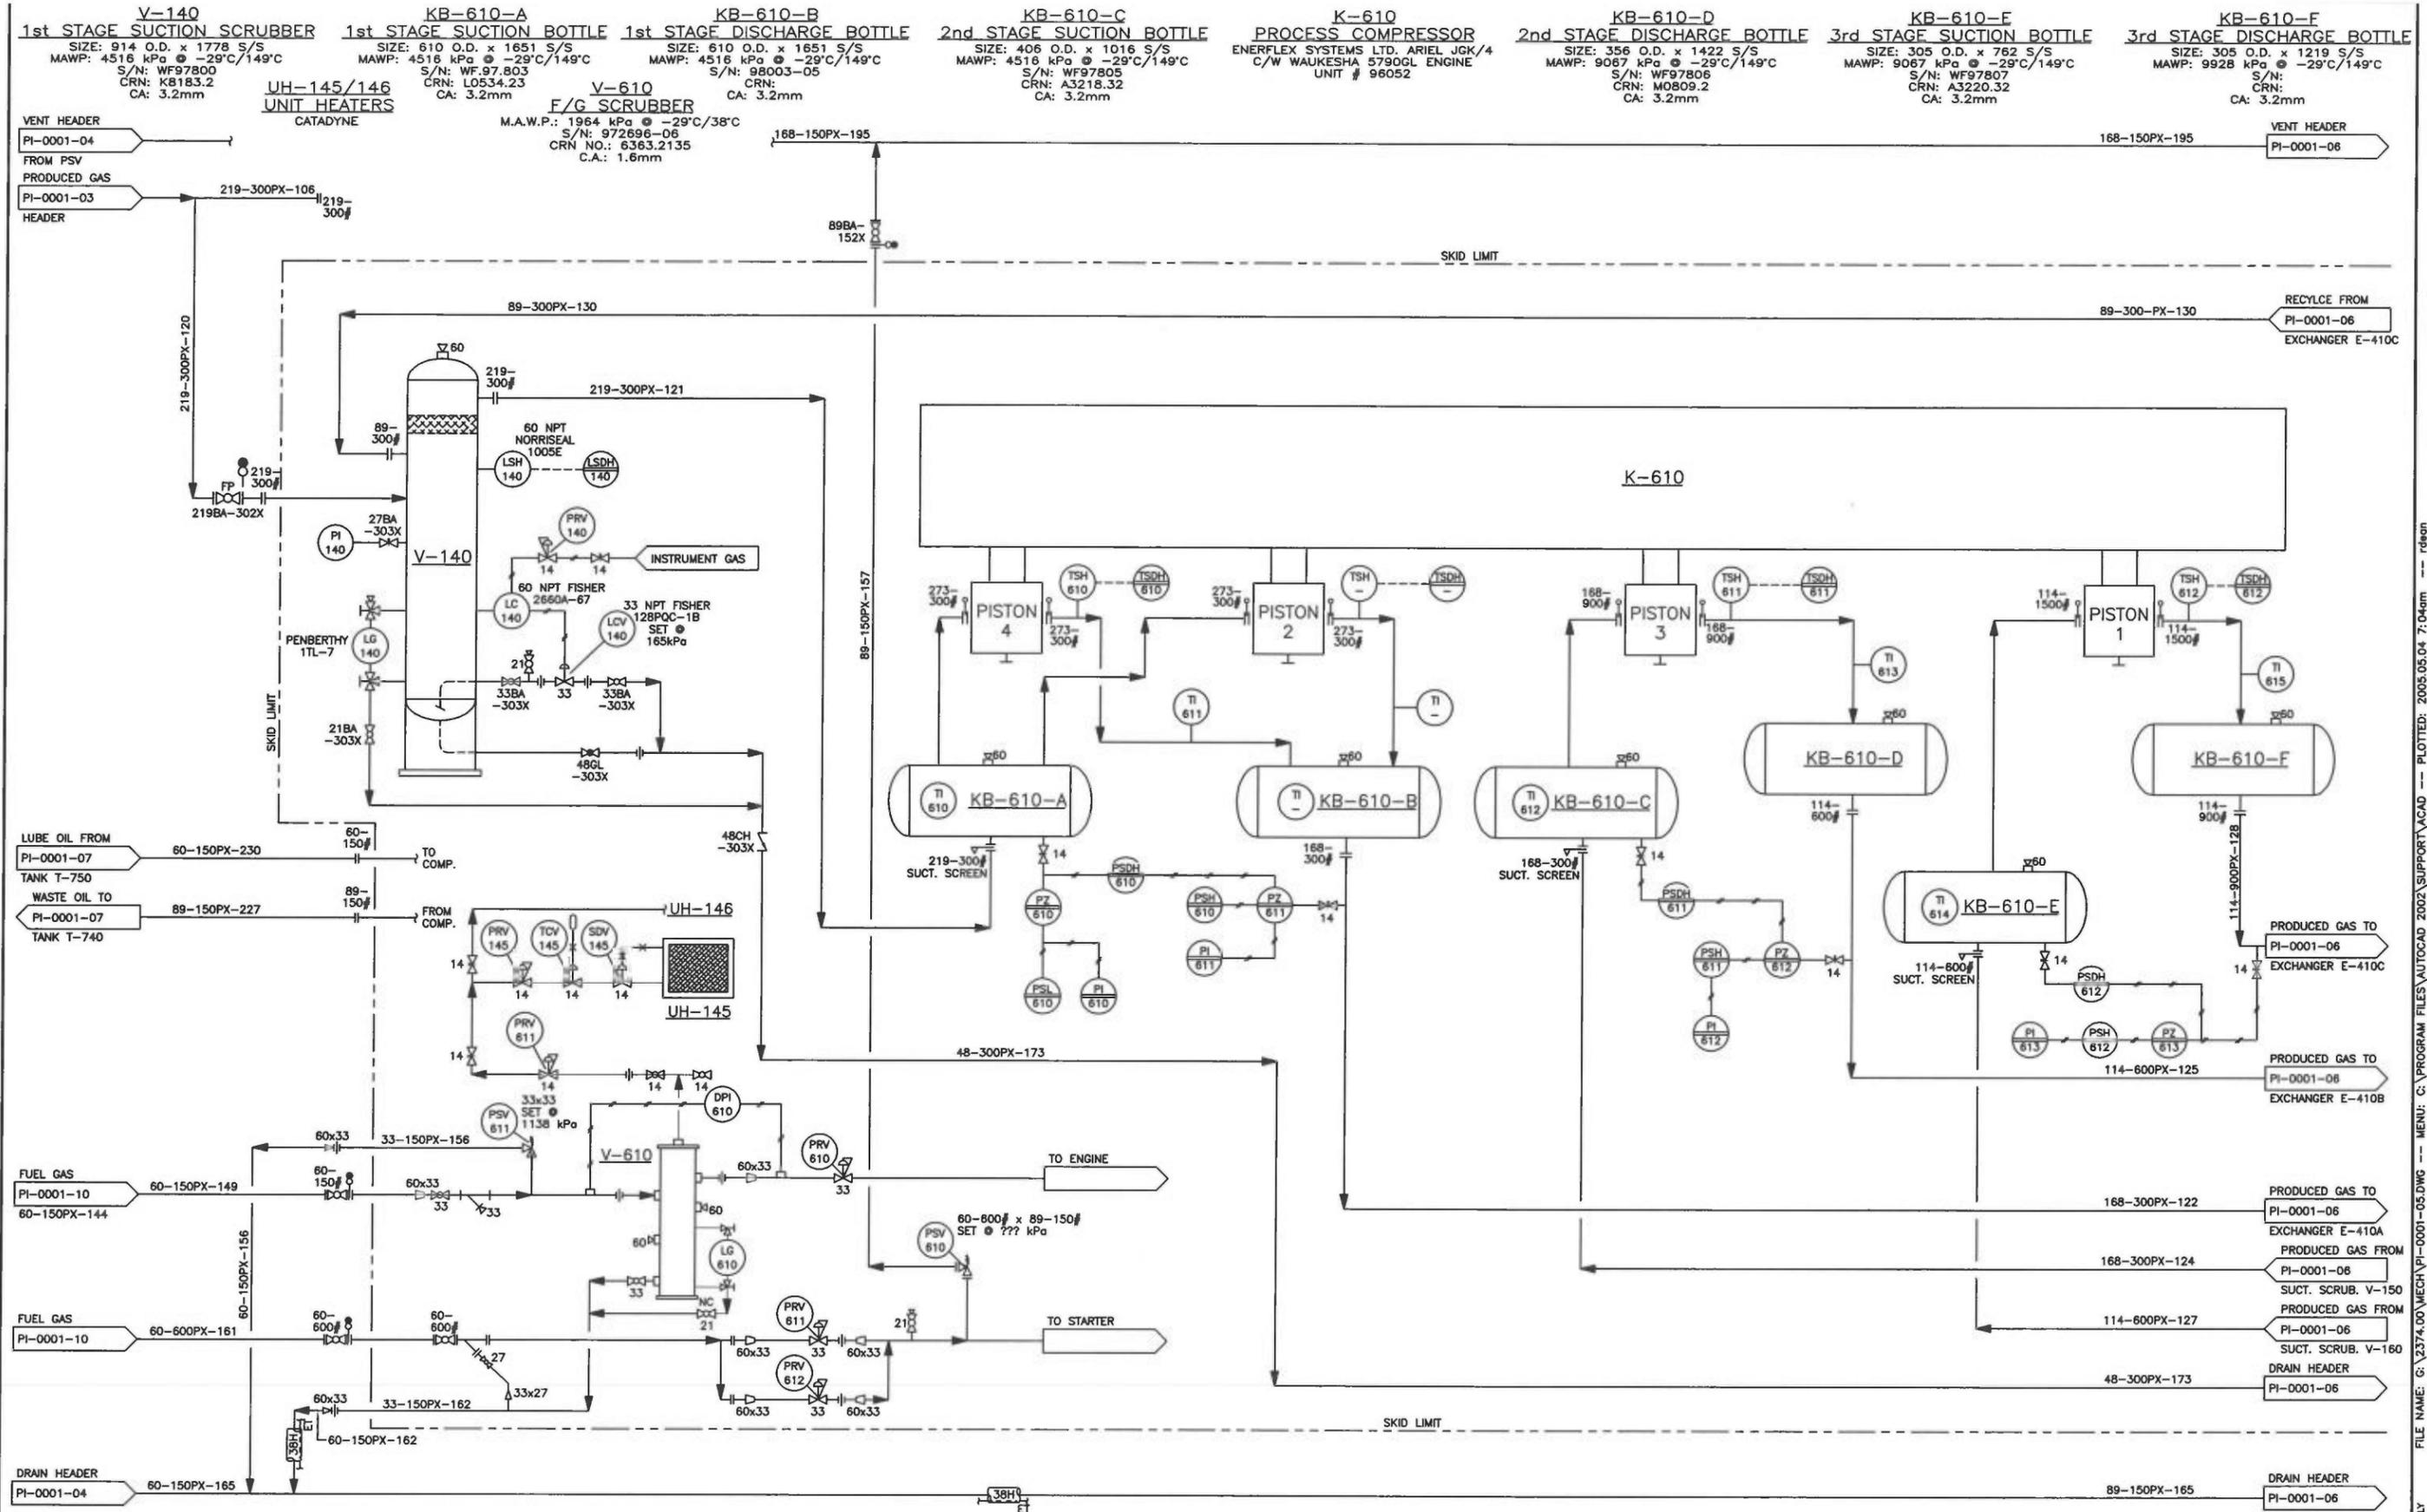

REF DWG NO	REFERENCE DRAWING DESCRIPTION	NO	REVISION HISTORY	REV AUTHOR	REV DATE	ISSUED FOR	NO	CURRENT REVISION	ISSUED FOR	AS-BUILT
		8	F-02389-F-00-01 REV.6 CONVERTED TO DWGS. PI-0001-01 TO 15	JM	05.02.21	REVISION	9	AS-BUILT (JOB #2374.00)	DOC DATE	01.07.19
		9	AS-BUILT (JOB #2374.00)	JM	05.02.21	AS-BUILT			DOC AUTHOR	CR
		10							SCALE	NTS
		11							ALTERNATE IDENTIFIER	
		12							SURFACE LSD	09-13-106-01W6
		13							DOCUMENT IDENTIFIER	PI-0001-05
		14								

Husky Energy

STEEN RIVER
LSD 09-13-106-01 W6M
COMPRESSOR STATION
PIPING & INSTRUMENTATION DIAGRAM

CAD DRAWING: DO NOT CHANGE MANUALLY
 FILE NAME: G:\2374.00\MECH\PI-0001-05.DWG -- MENU: C:\PROGRAM FILES\AUTOCAD 2002\SUPPORT\ACAD -- PLOTTED: 2005.05.04 7:04am -- rden