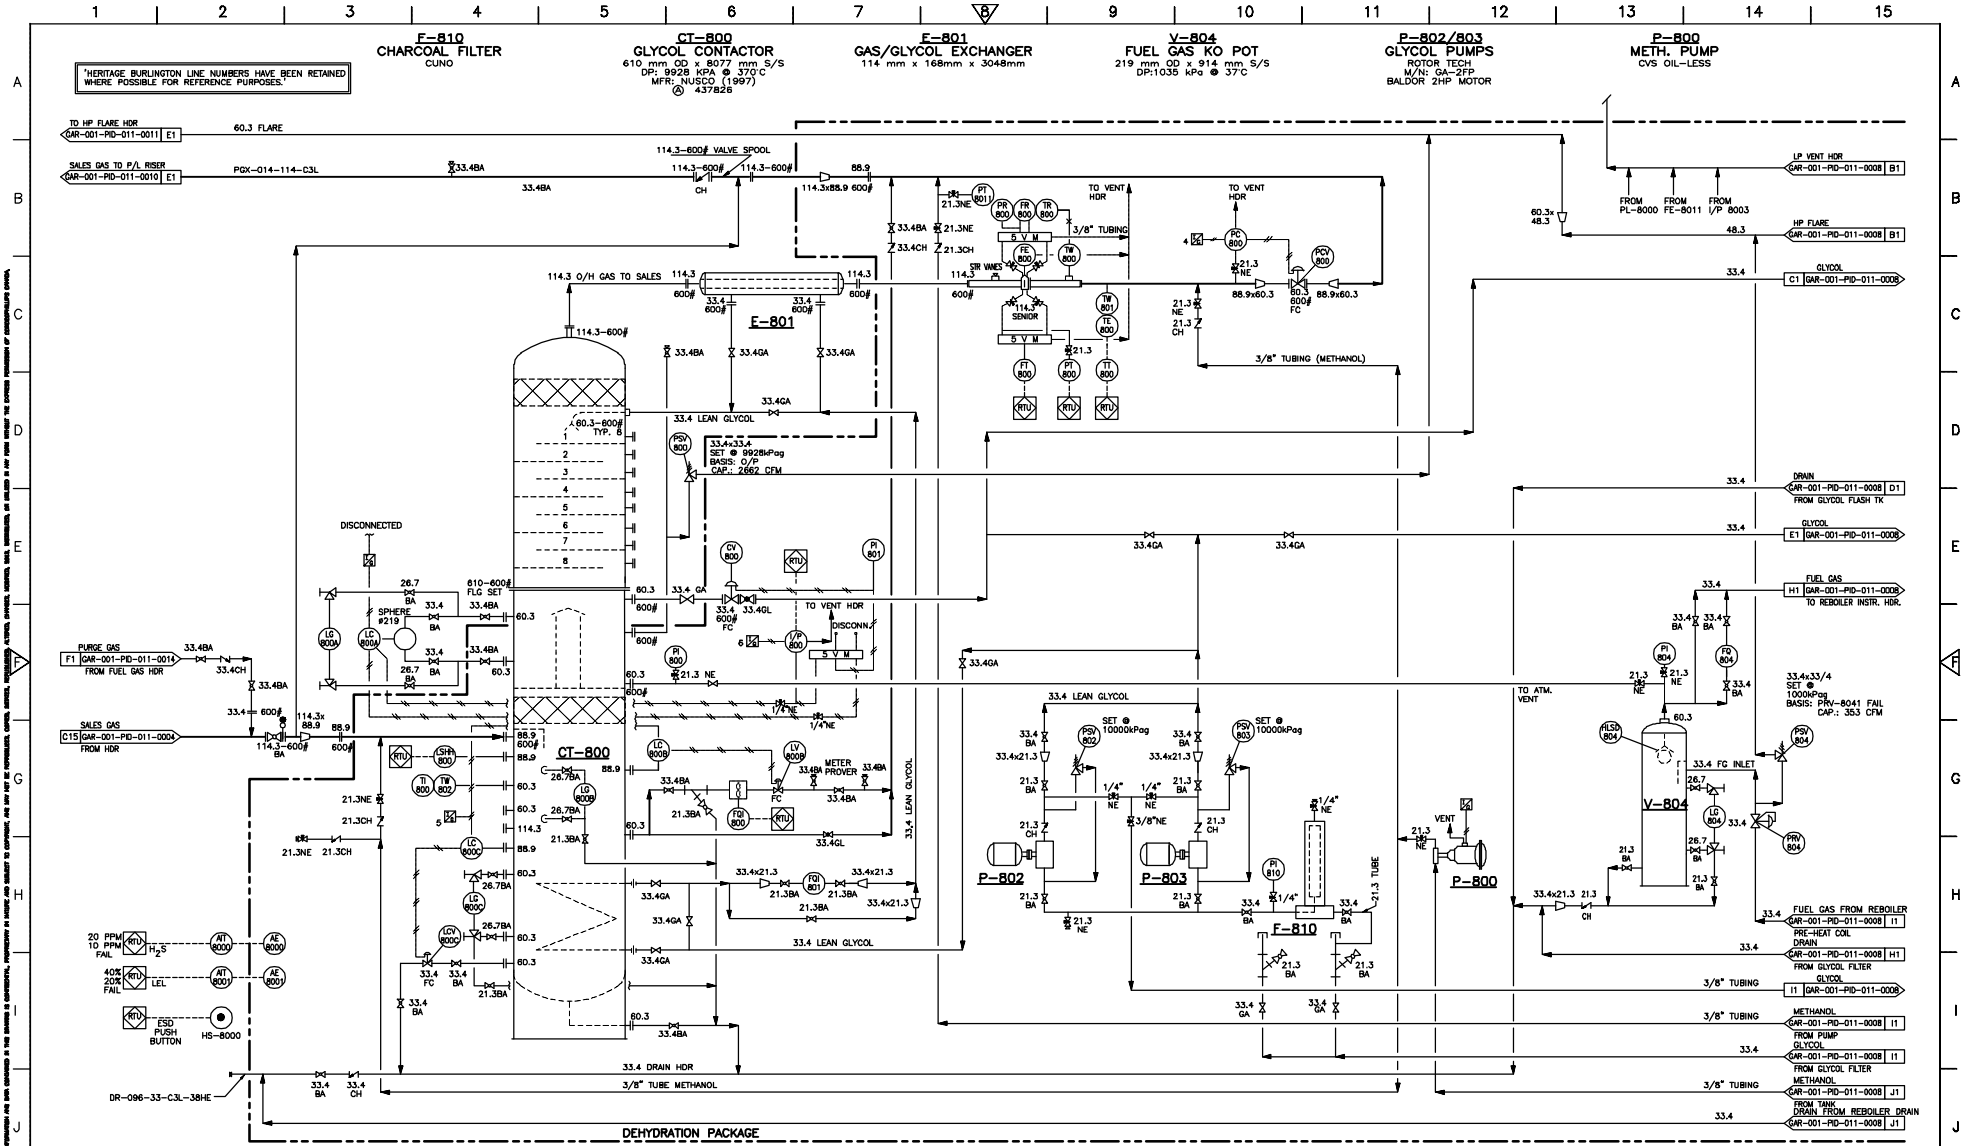

REFERENCE DRAWINGS		PROJECT VERSION (Clear cell info prior to returning to CPC)							REVISIONS						
DWG No.	TITLE	VER.	DATE	BY	CHK'D DFTG	CHK'D ENG	APP'D PM	VERSION ISSUE	REV.	DATE	BY	CHK'D DFTG	CHK'D ENG	APP'D PM	REVISION ISSUE
									4	07/06/16	LLZ				REDRAWN FROM DWG 03.031-032.01 (VECO 40092-0120)
									5	07/06/16	LLZ				AS-BUILT PER VECO MARK-UPS (VECO #40092-0120)
									6	09/02/16	AF				AS-BUILT PER CLIENT REDLINES NETWORK#10238817

ENGINEERING SEAL

PREPARED BY
VECO CANADA LTD.
Alliance Group

PERMIT

ConocoPhillips Canada

15-21 GARRINGTON CENTRAL GAS FACILITY

DEHYDRATOR
P&ID

LEGAL DESC. FROM:
15-21-36-05 W5M

LEGAL DESC. TO (IF APPL.):

LEGACY DWG NO.: 0120-P-D-0007
ENG. DL PROJ. NO.: 40092-0120

SCALE: N.T.S.
DATE: 07/05/16

CPC DWG. NO.: GAR-001-PID-011-0007

REV.: 6