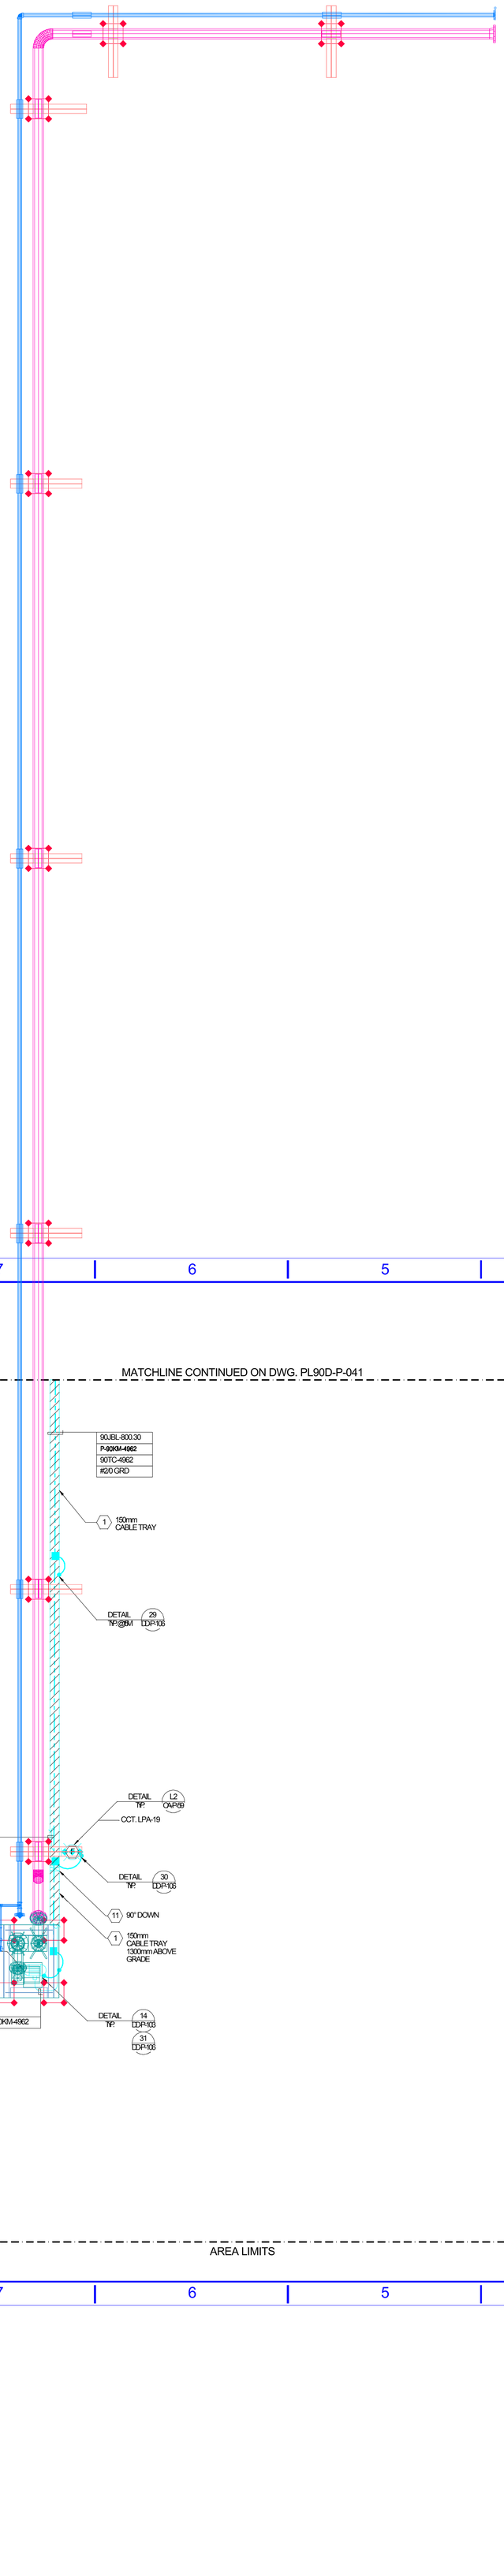

MATCHLINE CONTINUED ON DWG. PL90D-P-041

AREA LIMITS

AREA LIMITS

AREA LIMITS

REV. 1C

DRAWING NO. PL90D-P-0040

NOTES

REFERENCE DRAWINGS

KEY PLAN: KP90D-P-1
PIPING MODELS: PL90D-L-24/PL90D-L-17
EQUIPMENT MODELS:
CIVIL MODELS:
ELECTRICAL MODELS:

PREVIOUS REVISIONS

1	01	11	20	AS BUILT	CC	EN	DP	GP
0	01	07	13	ISSUED FOR FIELD CONSTRUCTION	CC	EN	DP	GP

PLANT ELEVATION 100.000 m = 594.200 ASL (GEODETIC EL.)

REV.	DATE Y	M	D	DESCRIPTION	BY	CHK	ENG.	APP.
1C	02	12	02	REVISED FOR NOVA MANAGE	CC	MG	DJA	GP

"THE SIGNED APEGGA STAMP RESIDES ON THE ORIGINAL DRAWING HELD IN DOCUMENT CONTROL. NO DESIGN CHANGES WILL BE MADE TO THIS DRAWING WITHOUT THE APPROVAL OF A REGISTERED ENGINEER."

APEGGA PERMIT TO PRACTICE MACDONALD ENGINEERING GROUP LTD. PERMIT NUMBER P 4545

SUNCOR ENERGY

THIS DRAWING, OWNED BY SUNCOR ENERGY, IS LOANED TO

WHOEVER RECEIVING IT HAS AGREED NOT TO REPRODUCE OR COPY IT IN WHOLE OR IN PART OR TO FURNISH INFORMATION FROM IT TO OTHERS, OR TO MAKE USE OF IT THAT IS, OR MAY BE INJURIOUS TO SUNCOR ENERGY AND TO RETURN IT UPON REQUEST.

1000 0 1000 2000

ALL DIMENSIONS ARE IN mm UNLESS NOTED OTHERWISE

PLOT SCALE: 1:1

Macdonald Engineering Group Ltd.
CALGARY ALBERTA CANADA

TITLE

LAYOUT DRAWING
FLARE STACK AREA
ELECTRICAL LAYOUT

EQUIP. NO. 90KM-4962/90F-4962		PLANT AREA 90-PILOT
EWR NO. 90-2002-002	SCALE 1:30	DGS FILE NAME PL90D-P-40REV1C.DWG
DRAWN BY C.CIOFFI	CHECKED BY E.NAGAN	MICRO. REV.
APPROVED	DRAWING NO. PL90D-P-0040	REV. 1C